




Executive Towers West II

1411 Opus Place
Downers Grove, Illinois

1st Floor – Suite 118

Existing As-Built Conditions
4,979 RSF

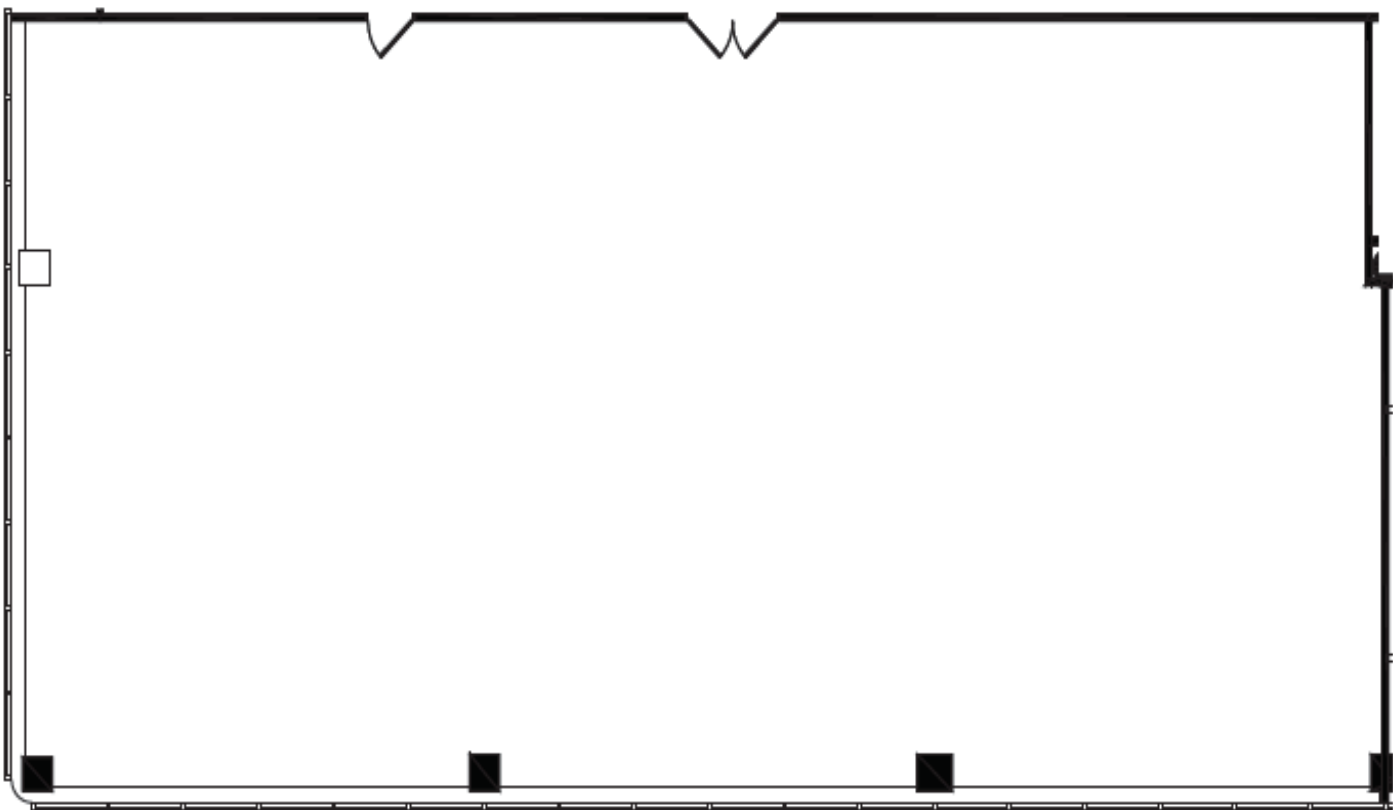

For further information, please contact our exclusive agents:

John Clark	Senior Managing Director	773.957.1410	jclark@ngkf.com
Rob Lundin	Senior Managing Director	773.957.1411	rlundin@ngkf.com
John Norris	Managing Director	773.957.1412	jnorris@ngkf.com