




Executive Towers West III

1400 Opus Place
Downers Grove, Illinois

1st Floor – Suite 110

Existing As-Built Conditions
5,096 RSF

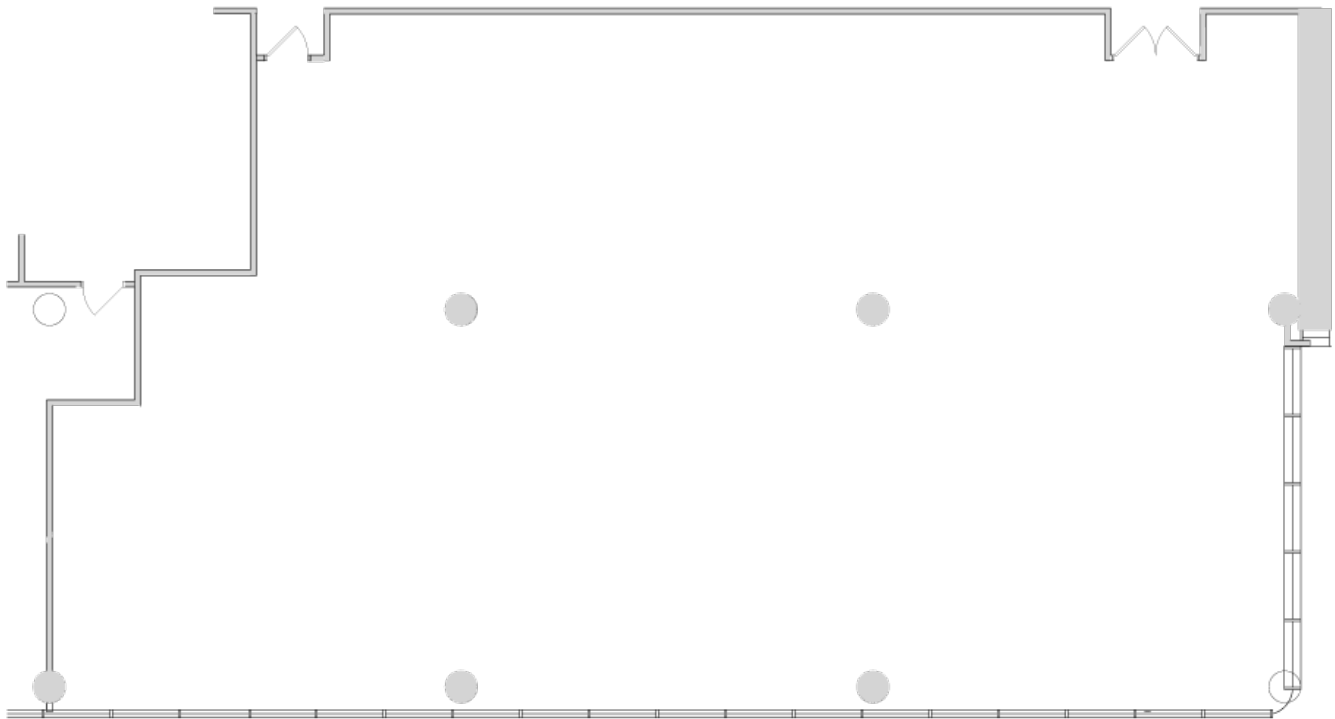

KEY PLAN



For further information, please contact our exclusive agents:

John Clark	Senior Managing Director	773.957.1410	jclark@ngkf.com
Rob Lundin	Senior Managing Director	773.957.1411	rlundin@ngkf.com
John Norris	Managing Director	773.957.1412	jnorris@ngkf.com